


SHEET 1 OF 5 SHEETS


63  
62  
61  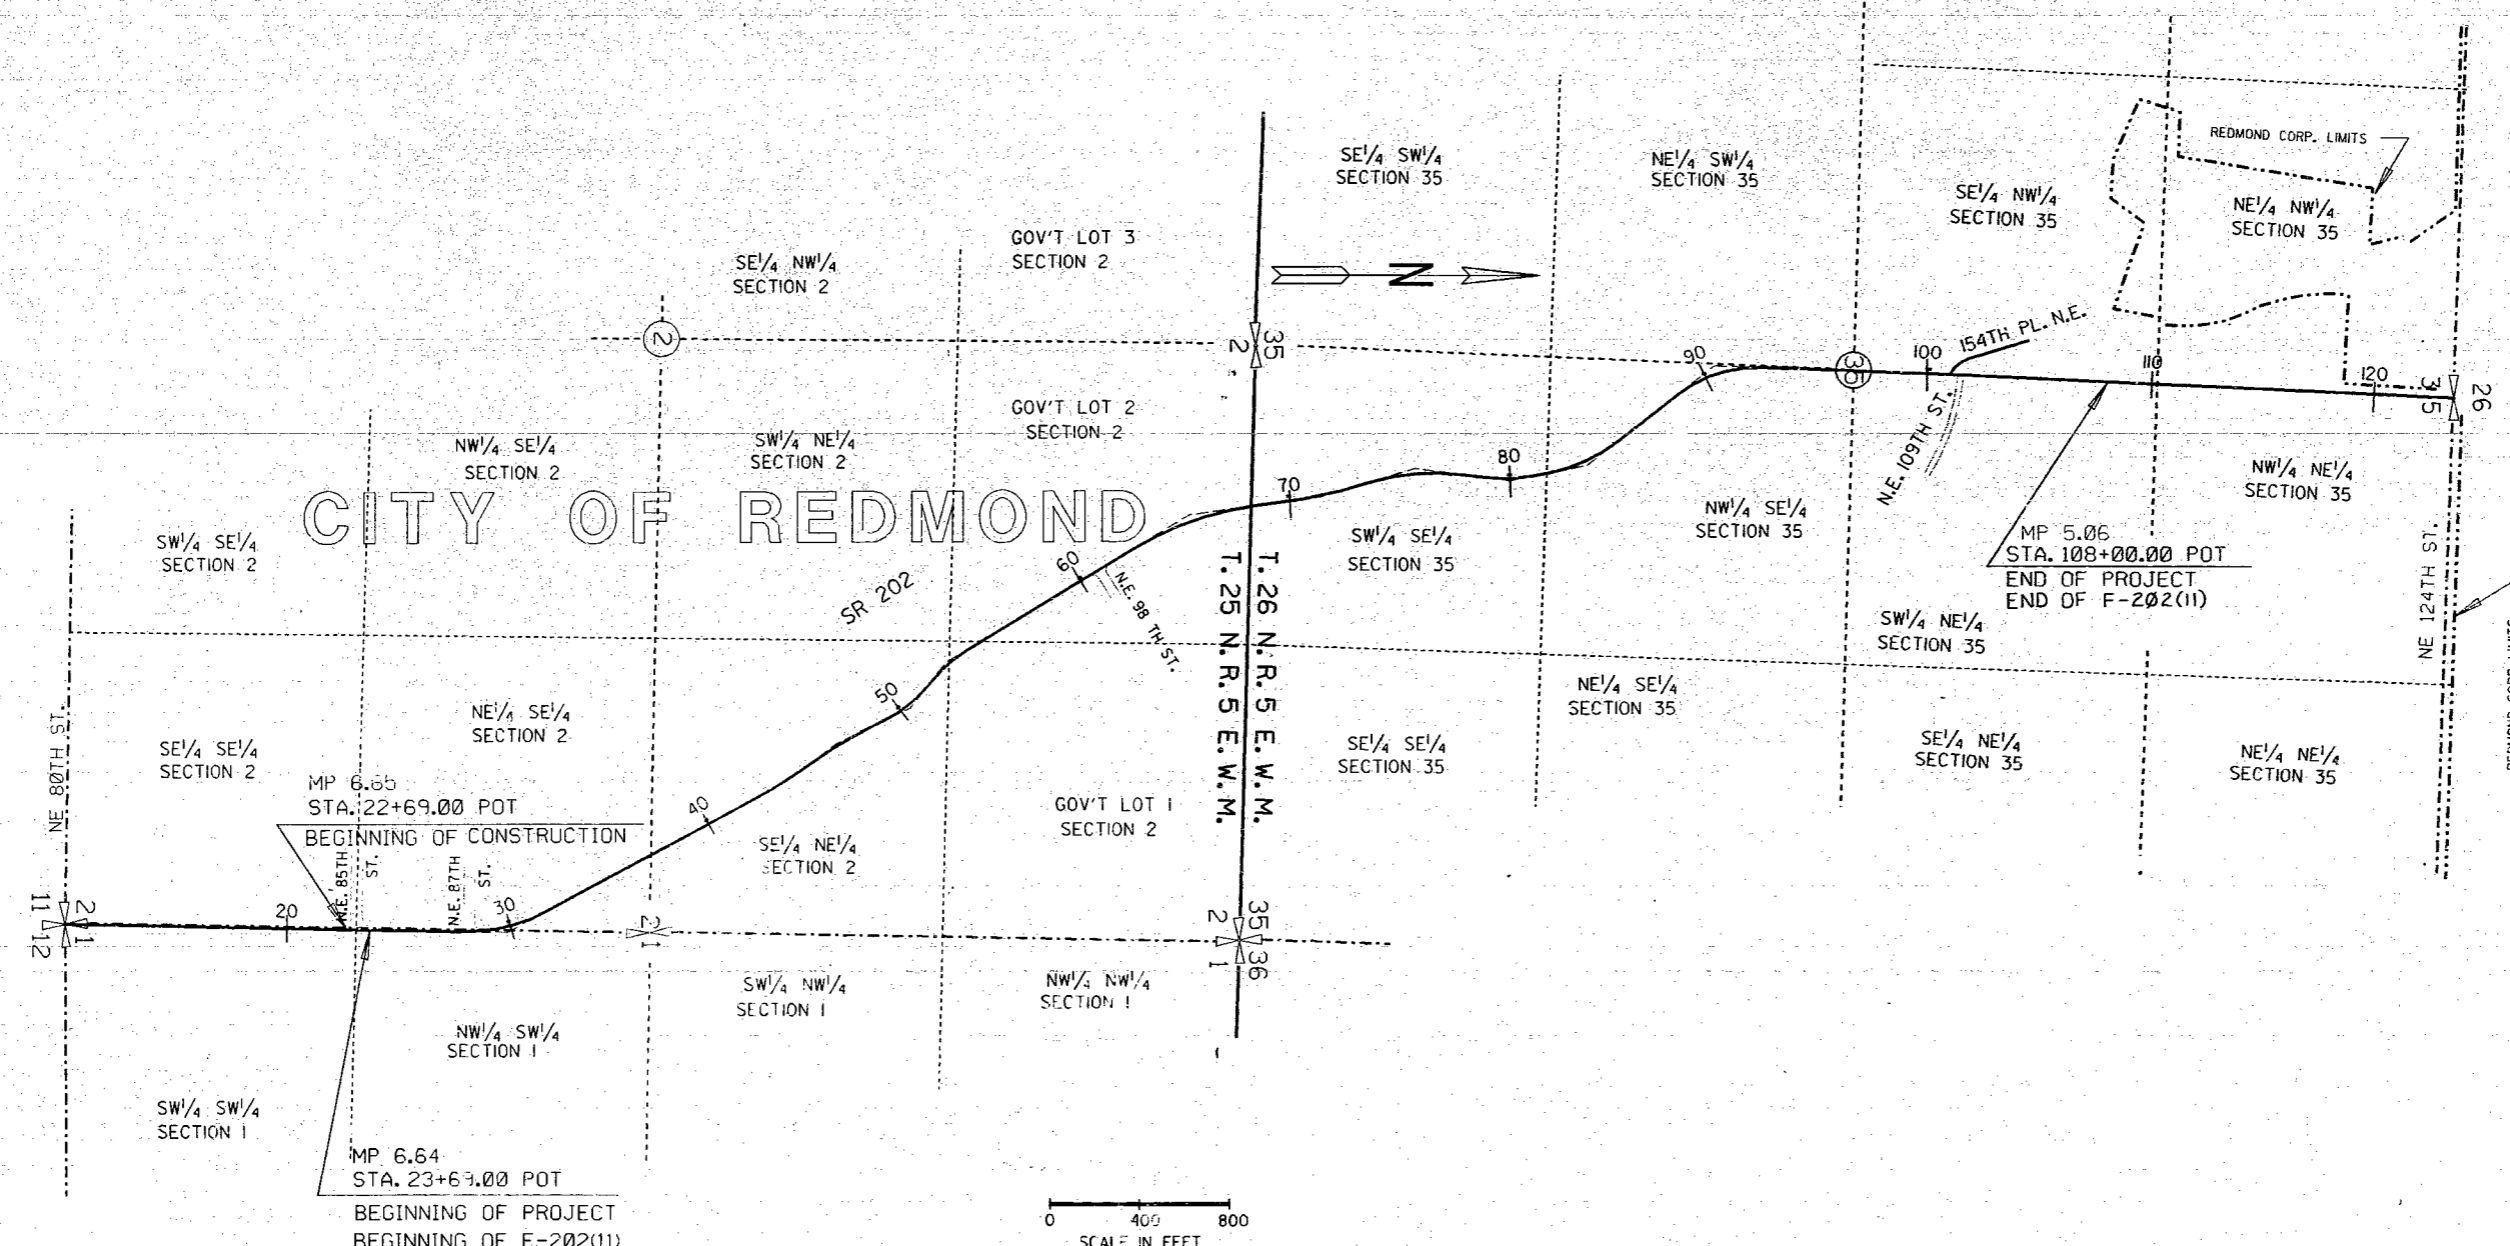
**AS-BUILT PLANS ONLY**

DESIGNED BY		REGION NO.	10	STATE	WASH.	 WASHINGTON STATE DEPARTMENT OF TRANSPORTATION	SR 202 NE 85TH ST. TO NE 109TH ST.	SHEET 1 THRU 24 SHEETS
ENTERED BY		DATE	12-14-84	PROJECT NO.	2858			
CHECKED BY		DATE		CONTRACT NO.		 NOV. 5, 1984 APPROVED PROJECT DEVELOPMENT ENGINEER	VICINITY MAP	
DIST. ADM.		REVISION	Deleted END OF CONSTRUCTION	BY	2858			


SR 202

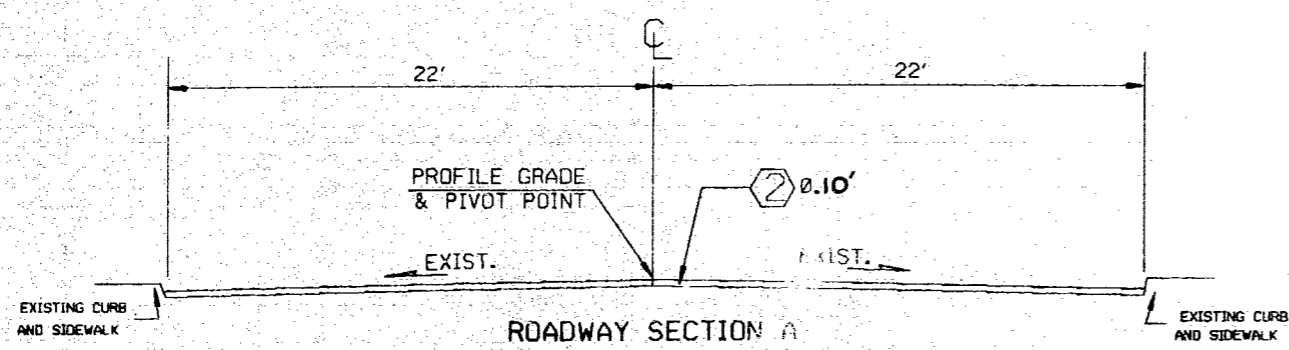


**ROADWAY SECTION A**  
 STA. 23+69.00 TO STA. 28+32.00  
 FEATHER ASPHALT TO CURB AS DIRECTED BY THE ENGINEER

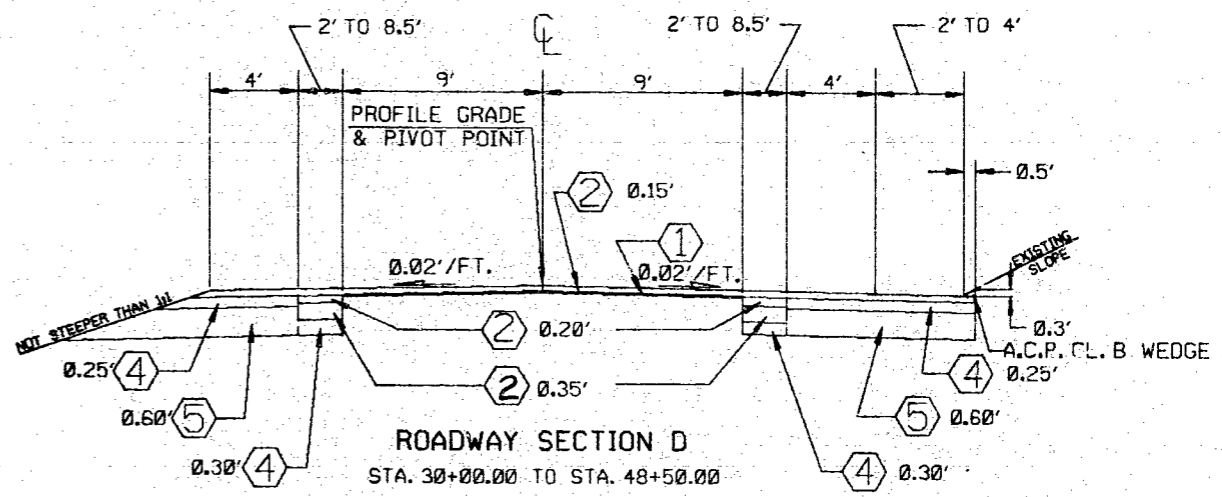

**ROADWAY SECTION D**  
 STA. 30+00.00 TO STA. 48+50.00  
 STA. 53+00.00 TO STA. 83+75.00  
 STA. 96+78.00 TO STA. 105+98.00

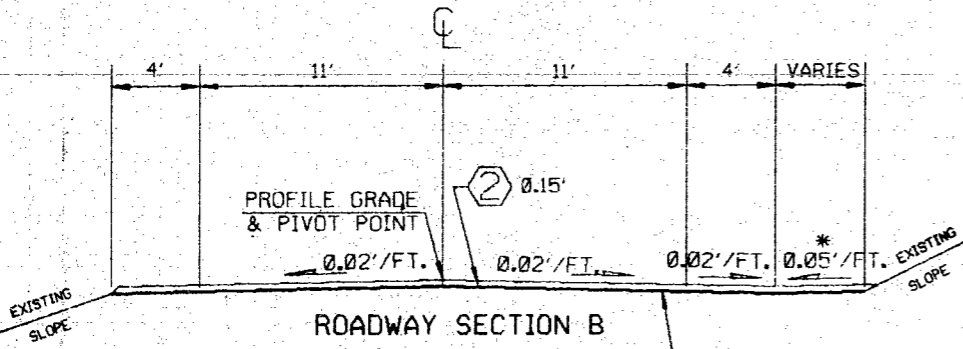

**ROADWAY SECTION B**  
 STA. 28+30.00 TO STA. 30+00.00  
 STA. 85+50.00 TO STA. 96+78.00  
 STA. 105+98.00 TO STA. 108+00.00

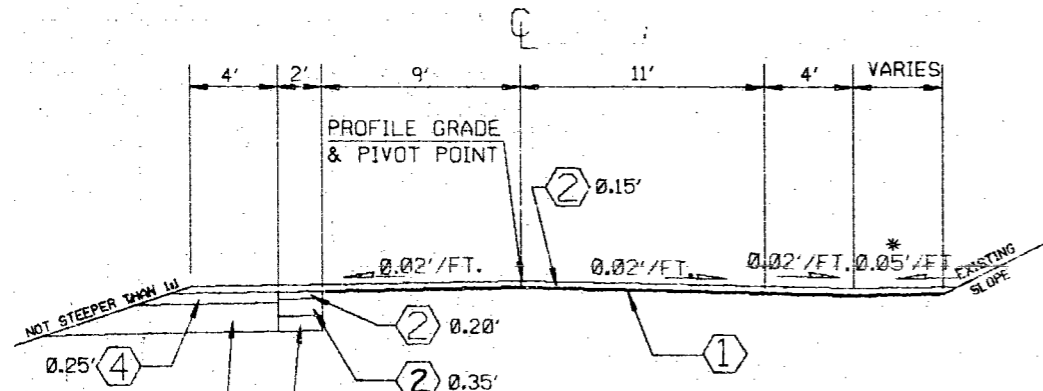


**ROADWAY SECTION C**  
 STA. 48+50.00 TO STA. 53+00.00  
 STA. 83+75.00 TO STA. 85+50.00


**SURFACING LEGEND**

- ① ASPHALT CONC. FOR PRELEVELING CL. B
- ② ASPHALT CONCRETE PAVEMENT CLASS B
- ③ NOT USED
- ④ CRUSHED SURFACING TOP COURSE
- ⑤ GRAVEL BORROW
- \*OR STEEPER TO MATCH EXISTING


All depths are compacted depths.

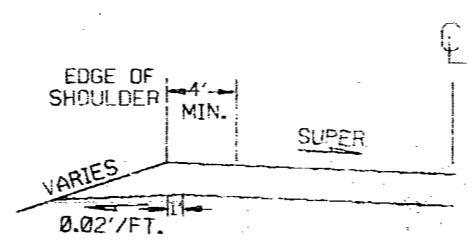

**LEFT SHOULDER DESIGN OUTSIDE OF CURVE**

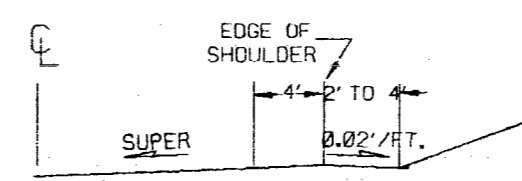

**RIGHT SHOULDER DESIGN OUTSIDE OF CURVE**

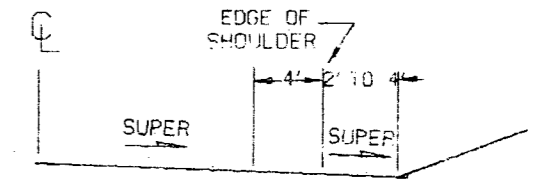








**RIGHT SHOULDER DESIGN INSIDE OF CURVE**

FOR "AS CONSTRUCTED PLANS" ONLY

DESIGNED BY		REGION NO.	STATE	FED. AID. PROJ. NO.	DIVISION OF HIGHWAYS	 WASHINGTON STATE DEPARTMENT OF TRANSPORTATION	SR 202 E 85TH ST. TO NE 109TH ST.
ENTERED BY		10	WASH	F-202(11)			
CHECKED BY		12-19-84		Added All depths are compacted			
PROJ. ENGR.		12-14-84		Del. INCL. PAVING ASPHALT			
DIST. ADM.		12-14-84		Revised ROADWAY SECTION A			
DATE	DATE	REVISION	BY	CONTRACT NO.	NOV. 5, 1984 APPROVED		

SR202/38

63  
62  
61  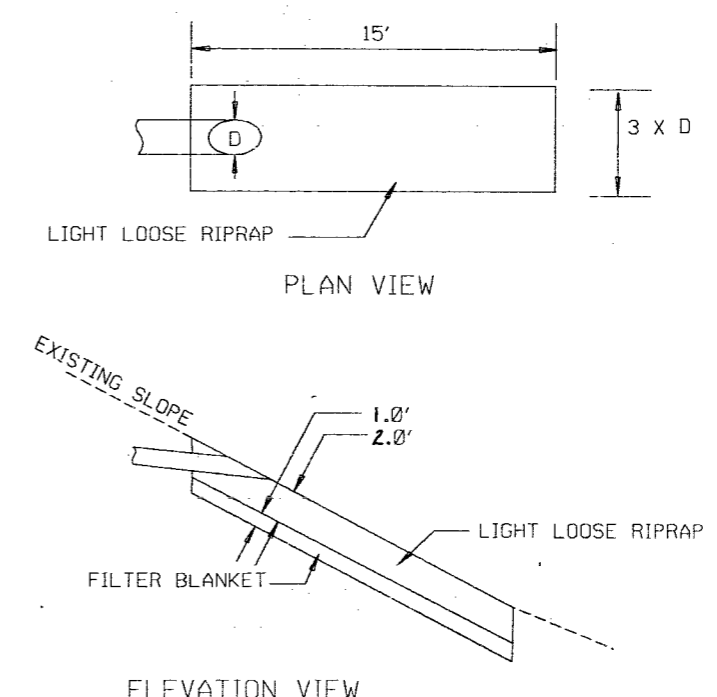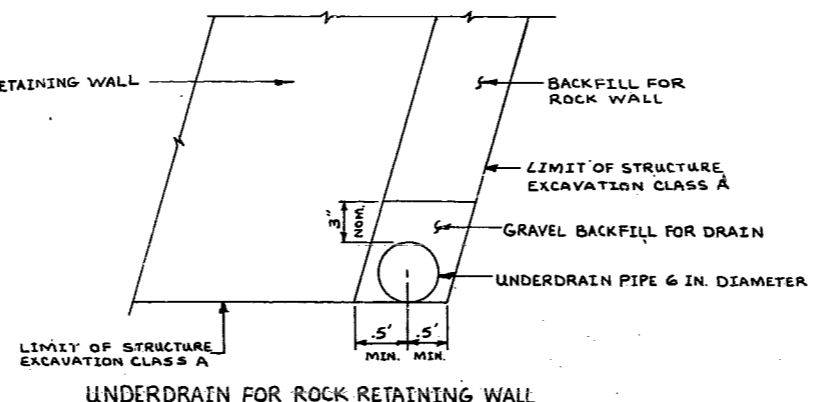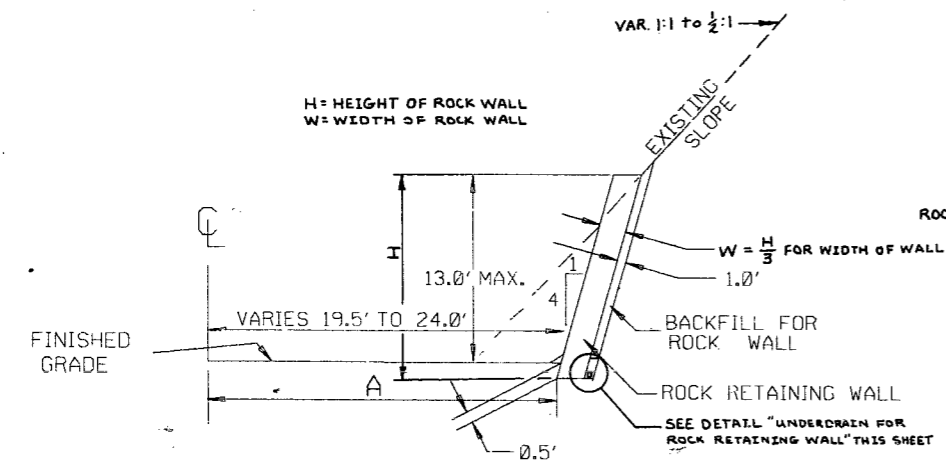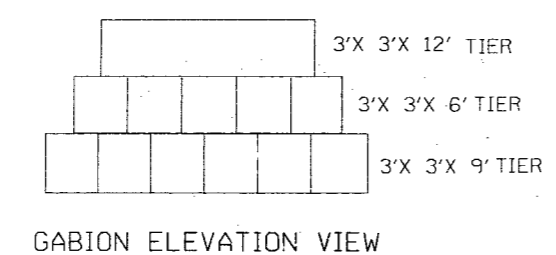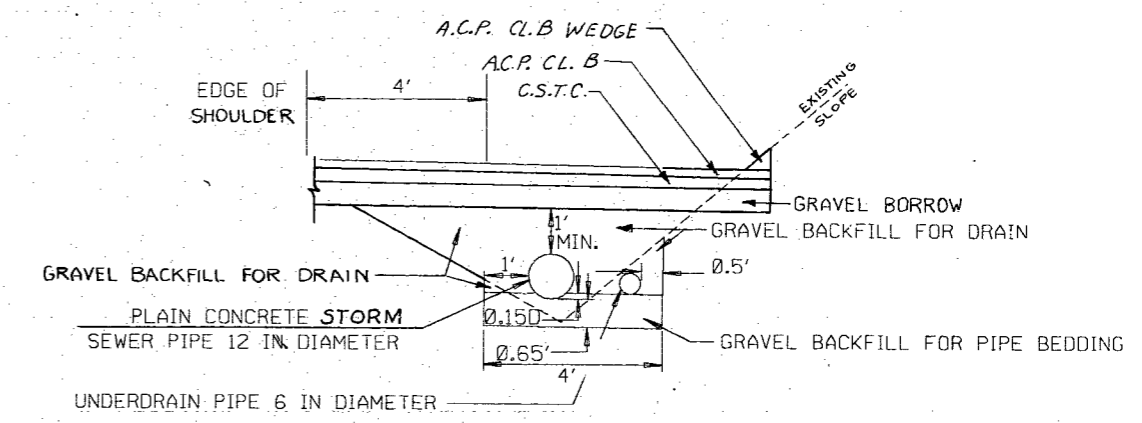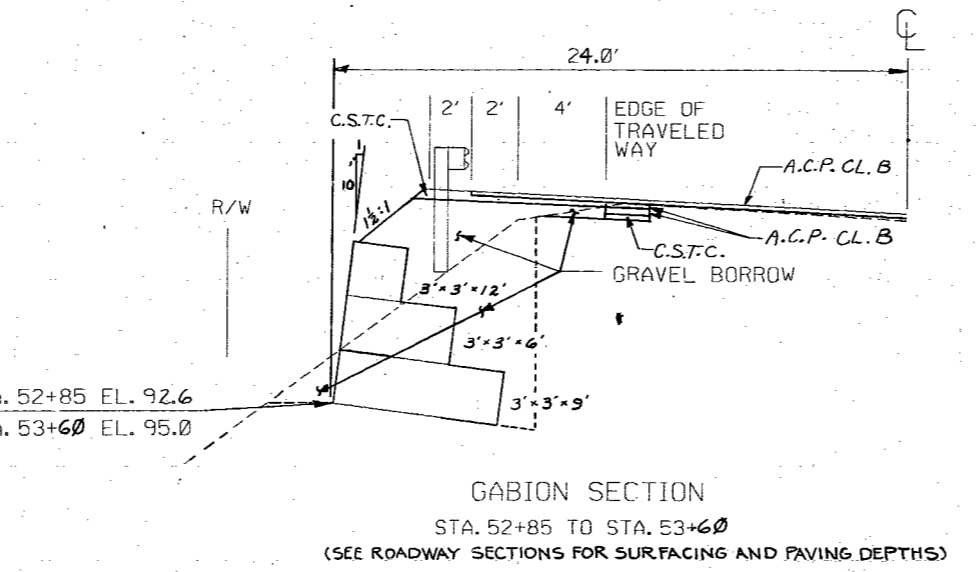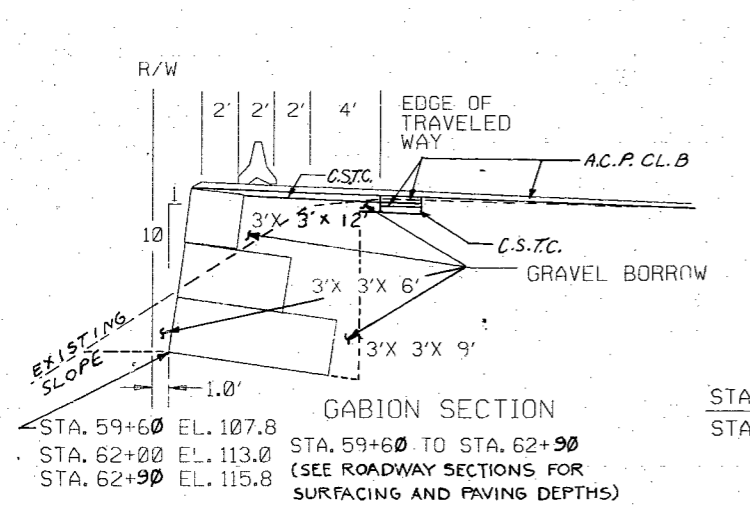
**ROCK RETAINING WALL DETAIL A**

STA. 58+25 TO STA. 60+25	19.5 TO 24.
STA. 61+75 TO STA. 62+75	24
STA. 62+75 TO STA. 63+75	24 TO 22.5
STA. 98+50 TO STA. 99+50	22 TO 24
STA. 99+50 TO STA. 101+00	24
STA. 102+25 TO STA. 103+50	24

**FOR "AS CONSTRUCTED PLANS" ONLY**

DESIGNED BY		REGION NO.	10	STATE	WASH	FED. AID. PROJ. NO.	F-202(11)	DIVISION OF HIGHWAYS		WASHINGTON STATE DEPARTMENT OF TRANSPORTATION	SR 202	85TH ST. TO NE 109TH ST.
ENTERED BY	12-19-84	Revised dimensions on RIPRAP PAD DETAIL	M.									
CHECKED BY	12-19-84	Changed stations & gravel borrow on Gabion Sections	M.									
PROJ. ENGR.	12-14-84	Added UNDERDRAIN FOR ROCK RETAINING WALL	M.									
DIST. ADM.	12-14-84	Revised ROCK RETAINING WALL DETAIL	M.									
	DATE	DATE										
			REVISION	BY	2958							

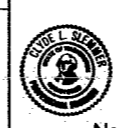


Nov. 5, 1984 APPROVED

ROCK WALL, GABIONS, DRAINAGE

SHEET 6 OF 24 SHEETS


SR 202

T. 25 N. R. 5 E. W.M.

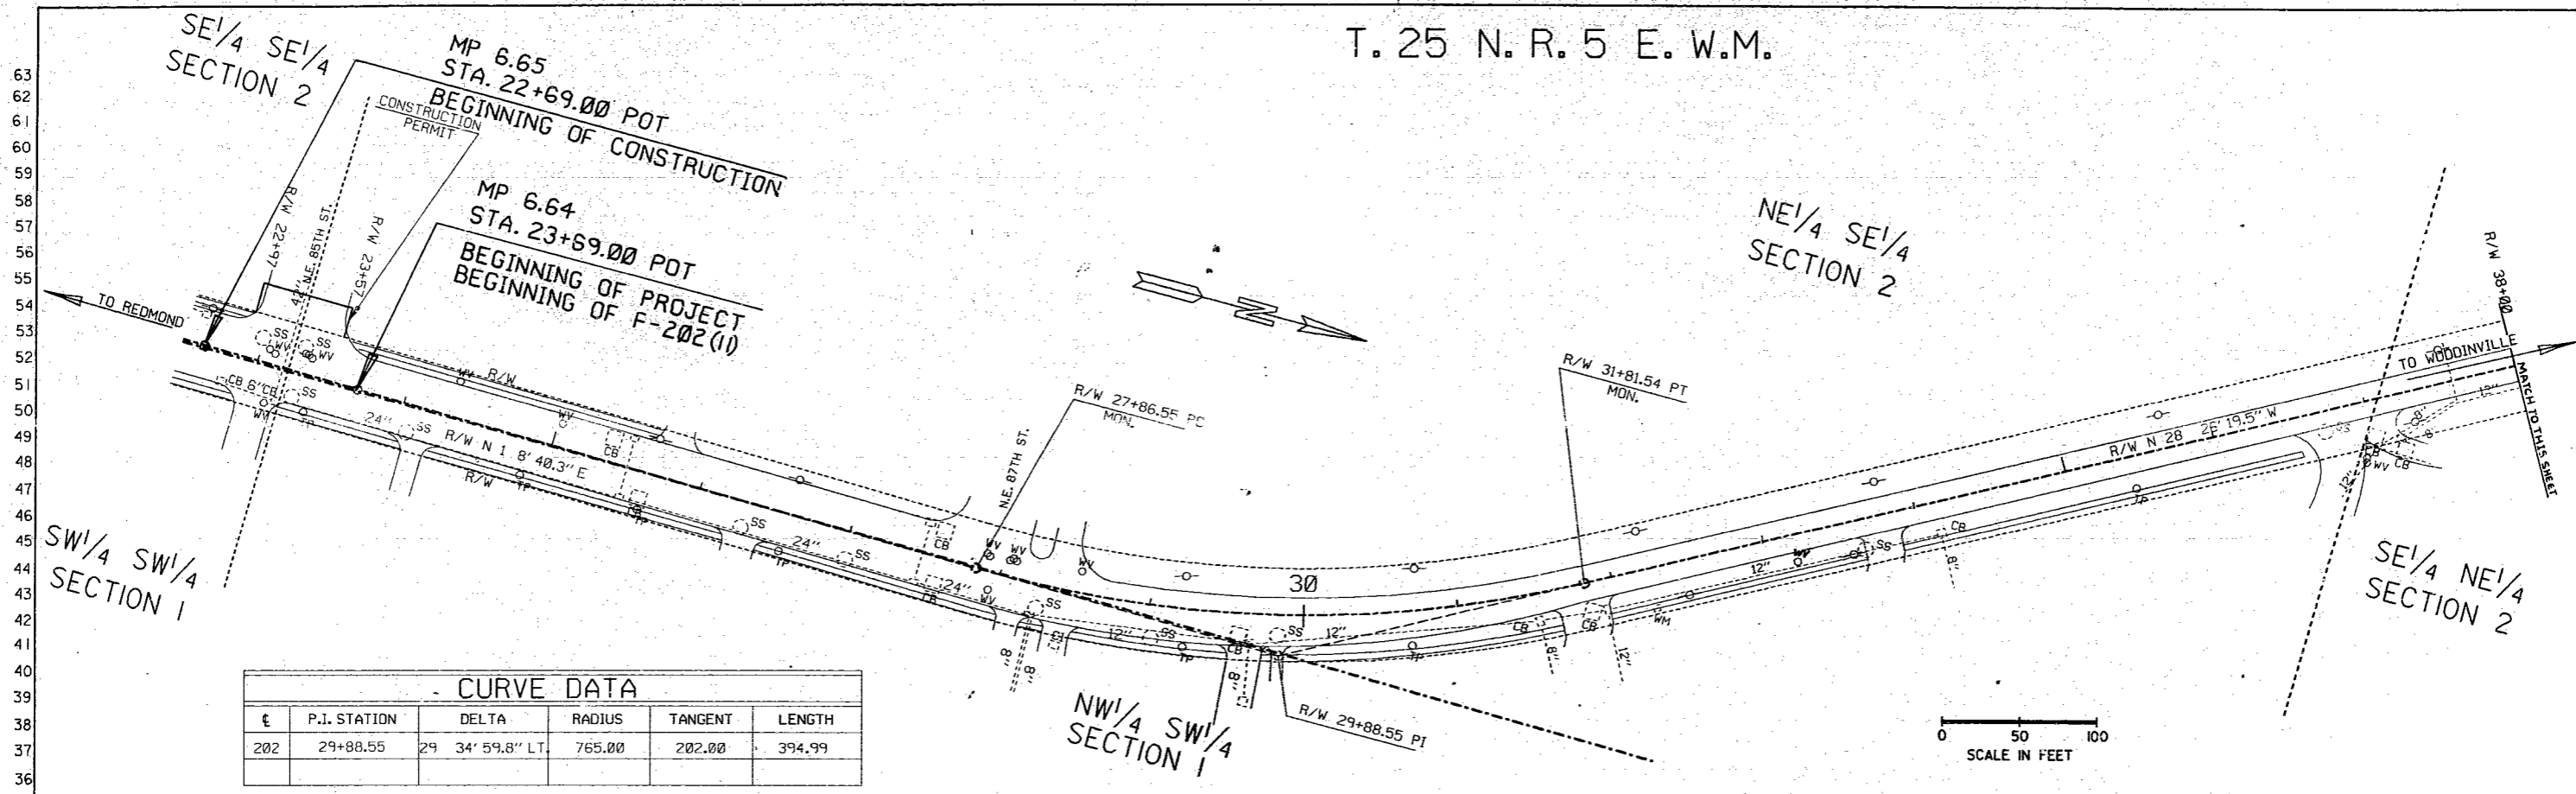


CURVE DATA

£	P.I. STATION	DELTA	RADIUS	TANGENT	LENGTH
202	29+88.55	29 34' 59.8" LT.	765.00	202.00	394.99

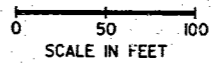


T. 25 N. R. 5 E. W.M.

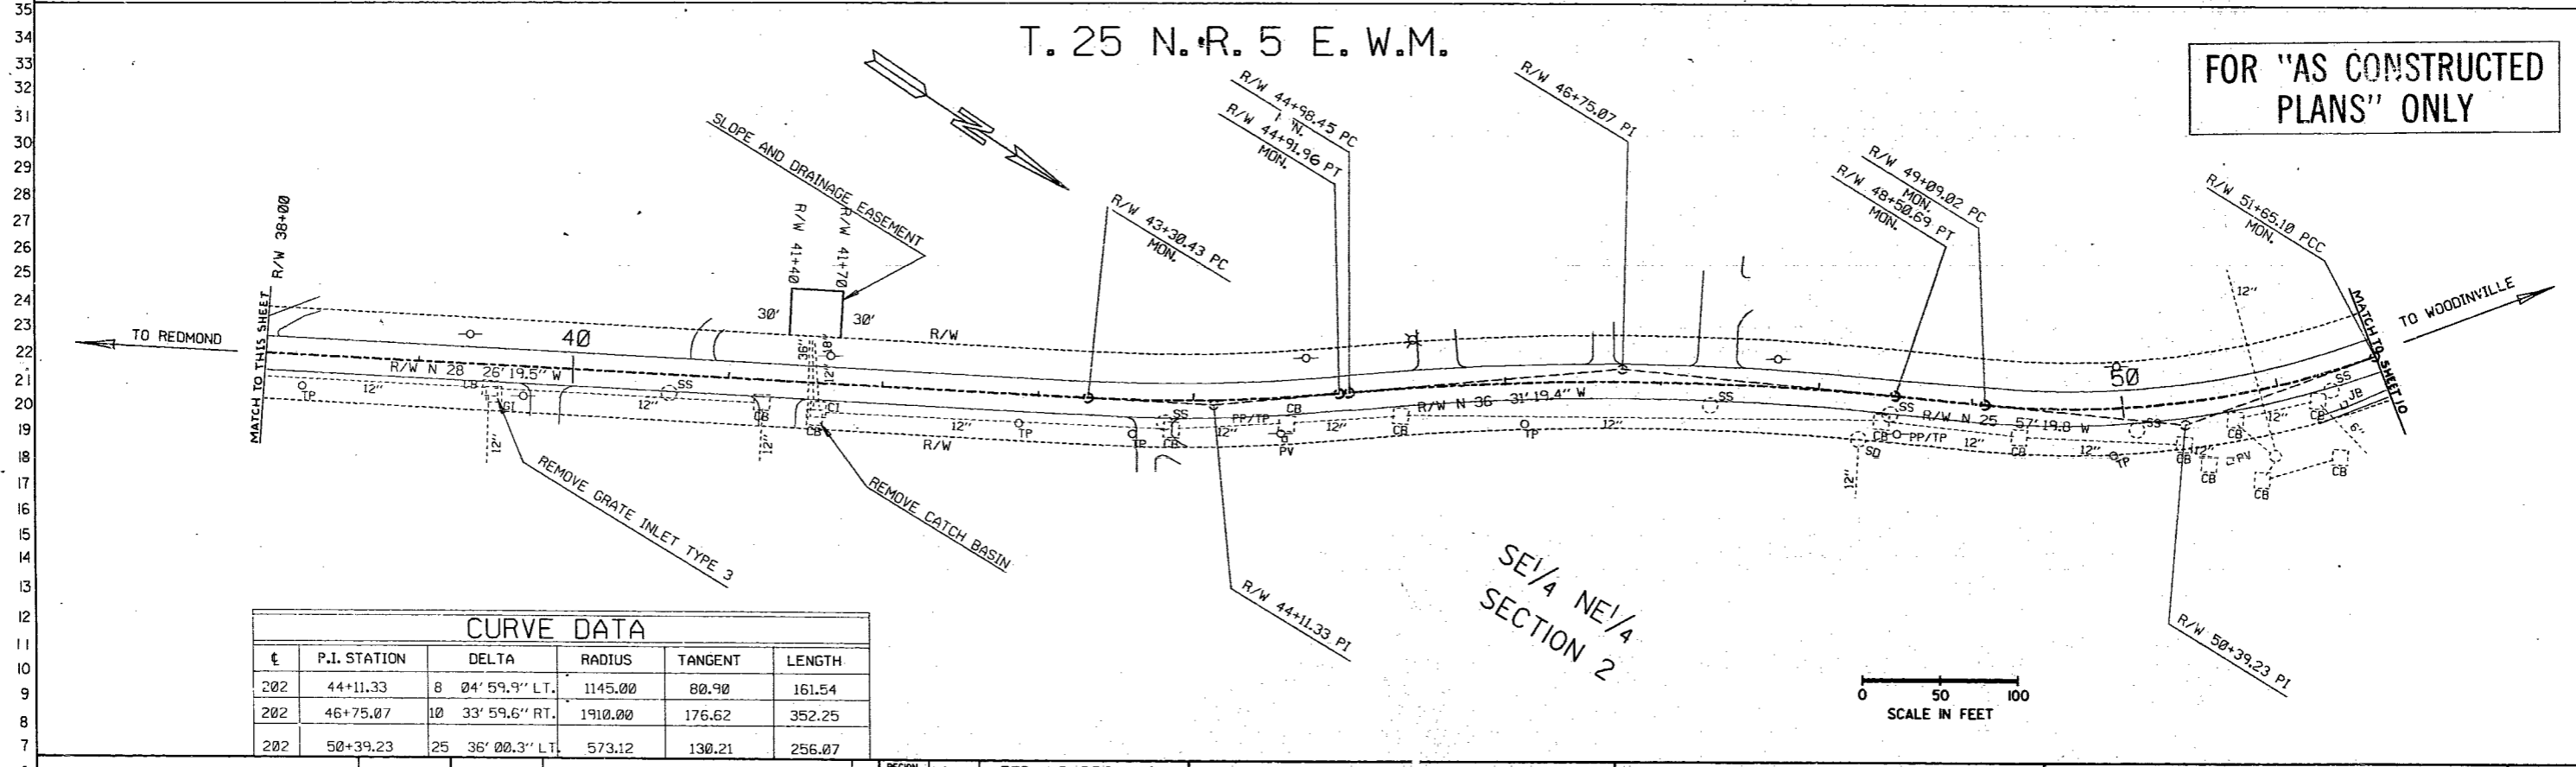

CURVE DATA

£	P.I. STATION	DELTA	RADIUS	TANGENT	LENGTH
202	44+11.33	8 04' 59.9" LT.	1145.00	80.90	161.54
202	46+75.07	10 33' 59.6" RT.	1910.00	176.62	352.25
202	50+39.23	25 36' 00.3" LT.	573.12	130.21	256.07

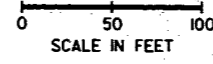

FOR "AS CONSTRUCTED PLANS" ONLY

DESIGNED BY ENTERED BY CHECKED BY PROJ. ENGR. DIST. ADM.	DATE DATE REVISION	BY 2858	REGION NO. 10	STATE WASH	FED. AID. PROJ. NO. F-202(11)	DIVISION OF HIGHWAYS WASHINGTON STATE DEPARTMENT OF TRANSPORTATION	<div style="border: 1px solid black; padding: 5px; text-align: center;"> <b>SR 202</b>  <b>NE 85TH ST. TO NE 109TH ST.</b> </div> <p style="text-align: center; font-weight: bold;">R/W PLAN</p>
			Nov. 5, 1984 APPROVED				

SHEET 9 OF 24


SR202/38








T. 25 N. R. 5 E. W.M.

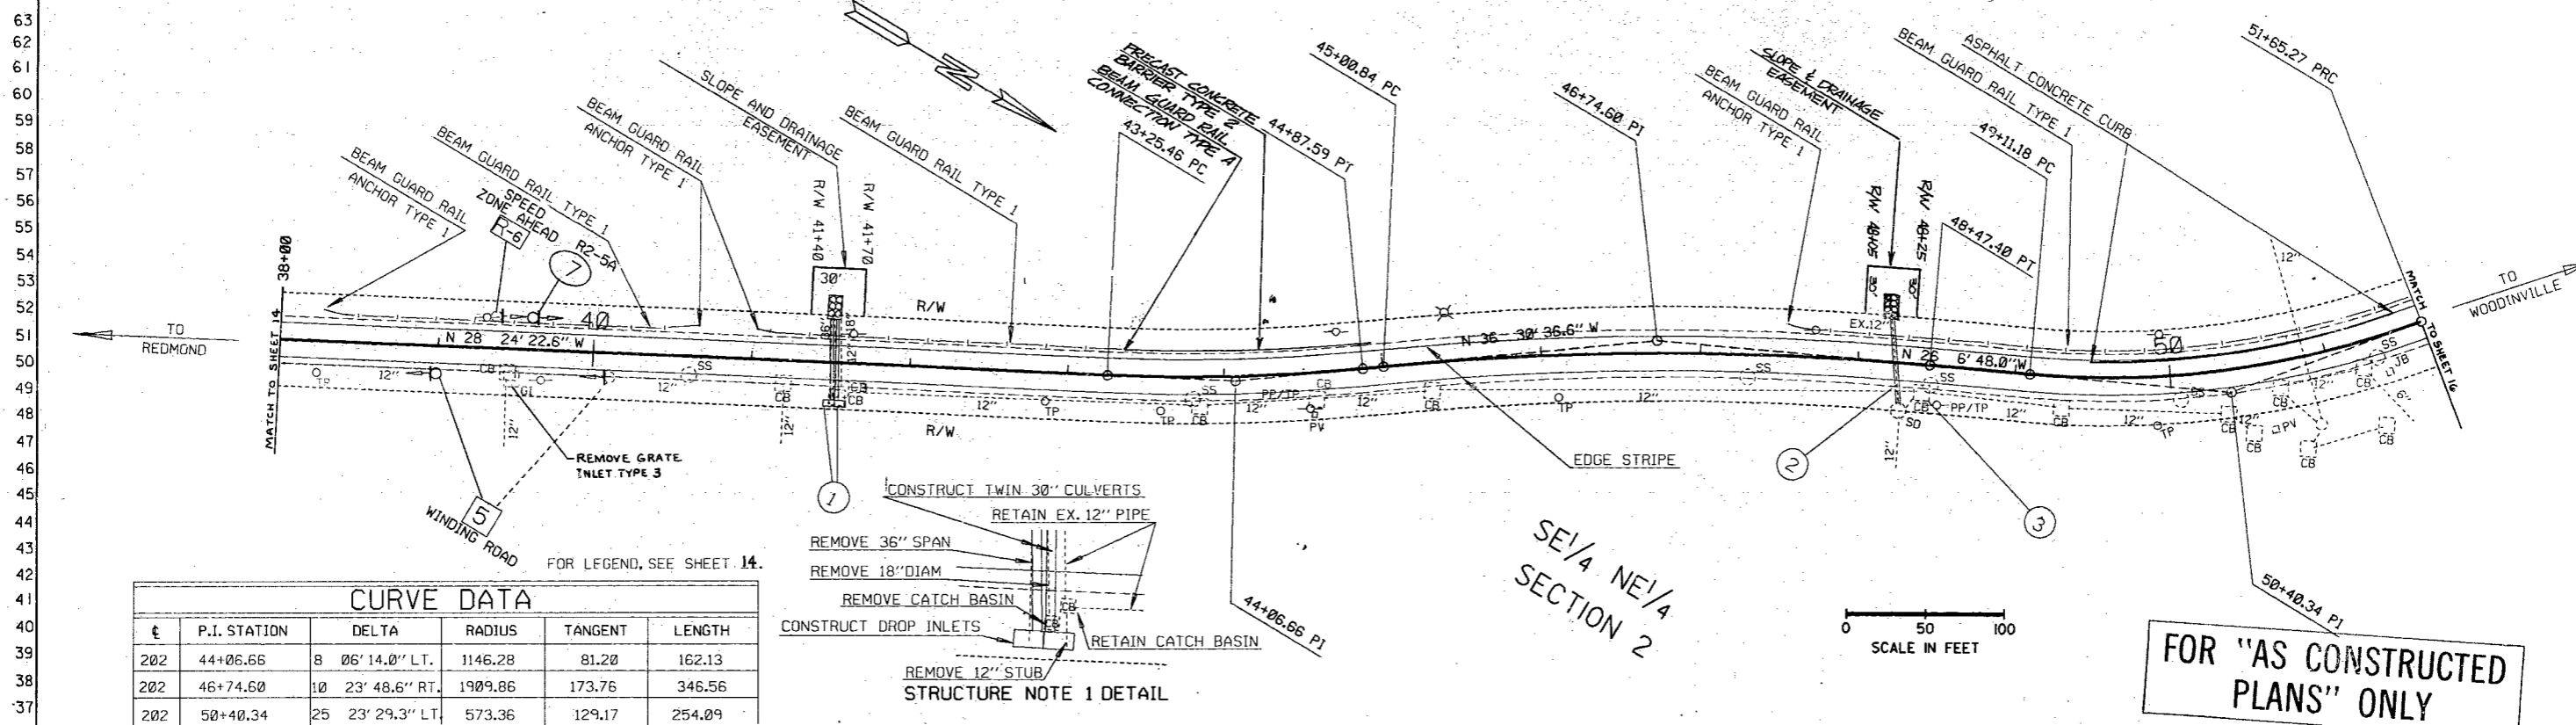


FOR LEGEND, SEE SHEET 14.


CURVE DATA					
€	P.I. STATION	DELTA	RADIUS	TANGENT	LENGTH
202	44+06.66	8 06' 14.0" LT.	1146.28	81.20	162.13
202	46+74.60	10 23' 48.6" RT.	1909.86	173.76	346.56
202	50+40.34	25 23' 29.3" LT.	573.36	129.17	254.09

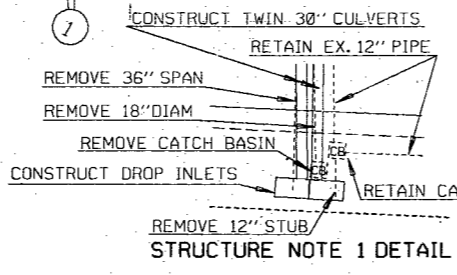

SE 1/4 NE 1/4 SECTION 2

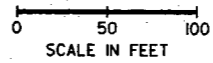

FOR "AS CONSTRUCTED PLANS" ONLY

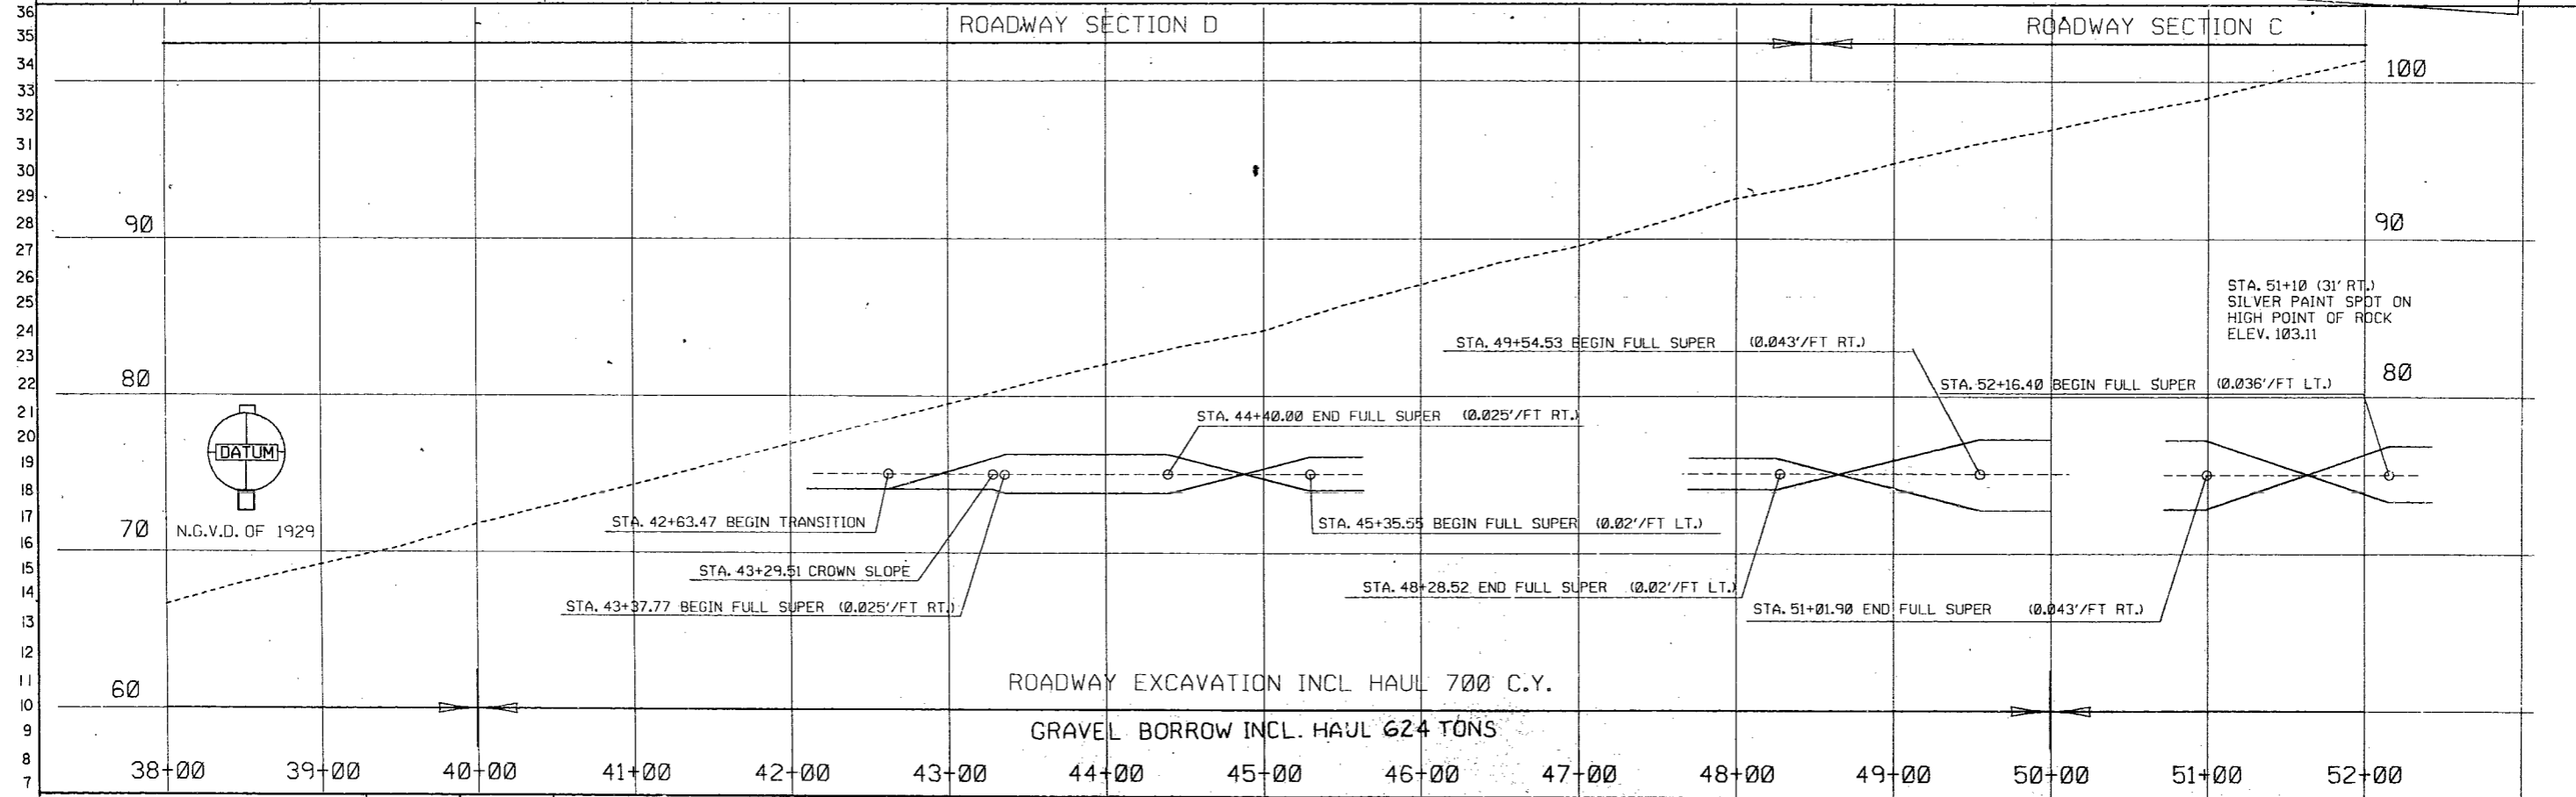

DESIGNED BY	ENTERED BY	CHECKED BY	PROJ. ENGR.	DIST. ADM.	DATE	DATE	REVISION	BY	<table border="1"> <tr> <td>REGION NO.</td> <td>STATE</td> <td>FED. AID. PROJ. NO.</td> </tr> <tr> <td>10</td> <td>WASH</td> <td>F-202(11)</td> </tr> <tr> <td>JOB NUMBER</td> <td colspan="2">84W189</td> </tr> <tr> <td>CONTRACT NO.</td> <td colspan="2">2858</td> </tr> </table>	REGION NO.	STATE	FED. AID. PROJ. NO.	10	WASH	F-202(11)	JOB NUMBER	84W189		CONTRACT NO.	2858				<p>SR 202</p> <p>E. 85TH ST. TO NE 109TH ST.</p>	<p>SHEET 15 OF 24 SHEETS</p> <p>SR002/38</p>
REGION NO.	STATE	FED. AID. PROJ. NO.																							
10	WASH	F-202(11)																							
JOB NUMBER	84W189																								
CONTRACT NO.	2858																								



Nov. 5, 1984 APPROVED

PLAN AND PROFILE

